NOTICE OF PENDING



NOTICE OF PENDING ACTION

result in the loss of the ability to appeal the County action on the application to the date the notice of pending action was sent. Failure to request a public hearing may member of the public may submit comments on the proposal prior to the deadline project will soon be made by Planning Department staff. Any listed on the reverse side of this notice. The project plans may be viewed on the decision date, which initiates an appeal period. Any member of the public may request a public hearing be held for this item within 15 working days from the Planning Department website (http://www.sccoplanning.com under Pending Public Notice Projects). The webpage may also be used to track the project An application for the project described on this notice has been filed and a Coastal Commission.

date and paying an appeal fee. Please be aware that, while an anticipated decision Any aggrieved person, or the applicant, may appeal the ultimate decision on this project by submitting a written request within 14 calendar days of the decision initiating the appeal period will be posted on the web address described above. Information regarding the appeal process or fees may be obtained by phoning date has been identified for purposes of this notice, the actual decision date

COUNTY OF SANTA CRUZ PLANNING DEPARTMENT 701 Ocean Street, 4th Floor Santa Cruz, CA 95060 (831) 454-2580

NOTICE OF PENDING ACTION

The Planning Department has received the following application. The identified planner may be contacted for specific information on this application.

APPLICATON NUMBER: 221192 APN: 043-152-54 SITUS ADDRESS: 625 Beach Drive, Aptos 95003

Proposal to recognize grading and installation of hardscape, and landscaping. Project includes removal of a 120 square foot nonhabitable storage shed. Requires a Coastal Development permit. Property located on both sides of Beach Drive approximately 1000 feet south of the Seacliff State Beach and access gate (625 Beach Drive).

OWNER: Kevin Huber APPLICANT: Kevin Huber SUPERVISORIAL DISTRICT: 2

PLANNER: Nathan MacBeth, (831) 454-3118 EMAIL: Nathan.MacBeth@santacruzcountv.us

Public comments must be received by 5:00 p.m. February 23, 2023.

A decision will be made on or shortly after February 24, 2023.

Appeals of the decision will be accepted until 5:00 p.m. two weeks after the decision date. If you would like to request a public hearing be held for this item, please contact the project planner listed on this notice. Information regarding the appeal process, including required fees, may be obtained by phoning (831) 454-2130.

For more information, contact the project planner identified above.

GENERAL NOTES

THE CONTRACTOR SHALL MAKE A DETAILED AND THOROUGH STUDY OF THESE PLANS IN THEIR ENTIRETY PRIOR TO ANY WORK ON THE JOBSITE. THE CONTRACTOR IS TO VERIFY ALL EXISTING CONSTRUCTION CONDITIONS AND IS TO COORDINATE THESE DRAWINGS WITH ALL OTHER TRADE DISCIPLINES FOR THE COMPLETED WORK. THE CONTRACTOR IS ALSO TO UNDERSTAND THAT ANY FEATURE OF CONSTRUCTION NOT FULLY SHOWN OR DETAILED SHALL BE OF THE SAME TYPE AS SHOWN FOR SIMILAR

2. THE CONTRACTOR SHALL IMMEDIATELY REPORT TO THE ENGINEER ANY DISCREPANCY OCCURRING ON THE DRAWINGS OR FOUND IN HIS COORDINATION WORK. NO CHANGES IN APPROVED PLANS SHALL BE MADE WITHOUT PRIOR WRITTEN APPROVAL OF THE PROJECT ENGINEER AND THE COUNTY OF SANTA CRUZ DEPARTMENT OF PUBLIC WORKS.

ANY REQUEST FOR ALTERATIONS OR SUBSTITUTIONS MUST BE PRESENTED DIRECTLY TO THE PROJECT ENGINEER, ACCOMPANIED BY A DETAILED SKETCH, FOR REVIEW, BEFORE ANY APPROVAL WILL BE GIVEN AND BEFORE PROCEEDING WITH THE WORK. ABSOLUTELY NO ALTERATIONS OF THESE DOCUMENTS OF ANY KIND WILL BE APPROVED ON ANY SHOP

4. ALL CONSTRUCTION SHALL CONFORM TO THE APPLICABLE PROVISIONS OF THE STATE OF CALIFORNIA STANDARD SPECIFICATIONS (CALTRANS), LATEST EDITION, THE COUNTY OF SANTA CRUZ DESIGN CRITERIA AND ALL APPLICABLE CODES AND ORDINANCES.

5. THE LOCATIONS OF EXISTING UTILITIES AS SHOWN ON THE PLANS WERE OBTAINED FROM RECORD DRAWINGS AND MAY NOT REPRESENT TRUE LOCATION. IT IS THE CONTRACTOR'S RESPONSIBILITY TO VERIFY THE LOCATION AND DEPTH OF THESE UTILITIES PRIOR TO CONSTRUCTION, AND TO NOTIFY THE PROJECT ENGINEER IN CASE OF CONFLICT.

6. THE CONTRACTOR SHALL SECURE ALL REQUIRED CONSTRUCTION PERMITS FROM THE COUNTY OF SANTA CRUZ PRIOR TO THE START OF WORK.

CONTRACTOR AGREES THAT IN ACCORDANCE WITH GENERALLY ACCEPTED CONSTRUCTION PRACTICES, CONTRACTOR WILL BE REQUIRED TO ASSUME SOLE AND COMPLETE RESPONSIBILITY FOR JOB SITE CONDITIONS DURING THE COURSE OF CONSTRUCTION OF THE PROJECT, INCLUDING SAFETY OF ALL PERSONS AND PROPERTY THAT THIS REQUIREMENT SHALL BE MADE TO APPLY CONTINUOUSLY AND NOT BE LIMITED TO NORMAL WORKING HOURS, AND CONTRACTOR FURTHER AGREES TO DEFEND, INDEMNIFY AND HOLD PROJECT ENGINEER HARMLESS FROM ANY AND ALL LIABILITY, REAL OR ALLEGED. IN CONNECTION WITH THE PERFORMANCE OF WORK ON THIS PROJECT, EXCEPTING LIABILITY RISING FROM THE SOLE NEGLIGENCE OF THE PROJECT ENGINEER.

8. GRADING SHALL BE DONE IN ACCORDANCE WITH THE RECOMMENDATIONS OF THE GEOTECHNICAL INVESTIGATIONS AND THE REQUIREMENTS OF THE COUNTY OF SANTA

9. THE CONTRACTOR SHALL NOTIFY THE COUNTY GRADING INSPECTOR, GEOTECHNICAL ENGINEER, THE CIVIL ENGINEER, & THE COUNTY CONSTRUCTION ENGINEER AT LEAST 48 HOURS PRIOR TO TO THE START OF CONSTRUCTION.

10. WORK SHALL BE LIMITED TO 8:00 A.M. TO 5:00 PM WEEKDAYS. NON-NOISE PRODUCING ACTIVITIES, SUCH AS INTERIOR PAINTING, SHALL NOT BE SUBJECT TO THIS

11. ALL FIGURE (FIG.) REFERENCES, UNLESS OTHERWISE SPECIFIED, REFER TO STANDARD DRAWINGS IN THE CURRENT EDITION OF THE "COUNTY OF SANTA CRUZ DESIGN CRITERIA."

12. NO LAND CLEARING, GRADING OR EXCAVATING SHALL TAKE PLACE BETWEEN OCTOBER 15 AND APRIL 15 UNLESS THE PLANNING DIRECTOR APPROVES A SEPARATE WINTER EROSION CONTROL PLAN.

13. BETWEEN OCTOBER 15 AND APRIL 15, EXPOSED SOIL SHALL BE PROTECTED FROM EROSION AT ALL TIMES. DURING CONSTRUCTION SUCH PROTECTION MAY CONSIST OF MULCHING AND/OR PLANTING OF NATIVE VEGETATION OF ADEQUATE DENSITY. BEFORE COMPLETION OF THE PROJECT, ANY EXPOSED SOIL ON DISTURBED SLOPES SHALL BE PERMANENTLY PROTECTED FROM EROSION.

14. THE CONTRACTOR SHALL APPLY WATER TO ALL EXPOSED EARTH SURFACES AT INTERVALS SUFFICIENT TO PREVENT AIRBORNE DUST FROM LEAVING THE PROJECT SITE. ALL EXPOSED EARTH SHALL BE WATERED DOWN AT THE END OF THE WORK DAY.

15. WHILE IN TRANSIT TO AND FROM THE PROJECT SITE, ALL TRUCKS TRANSPORTING FILL SHALL BE EQUIPPED WITH TARPS.

16. PURSUANT TO SECTIONS 16.40.040 AND 16.42.100 OF THE COUNTY CODE, IF AT ANY TIME DURING SITE PREPARATION, EXCAVATION, OR OTHER GROUND DISTURBANCE ASSOCIATED WITH THIS DEVELOPMENT, ANY ARTIFACT OR OTHER EVIDENCE OF AN HISTORIC ARCHEOLOGICAL RESOURCE OR A NATIVE AMERICAN CULTURAL SITE IS DISCOVERED. THE RESPONSIBLE PERSONS SHALL IMMEDIATELY CEASE AND DESIST FROM ALL FURTHER SITE EXCAVATION AND NOTIFY THE SHERIFF-CORONER IF THE DISCOVERY CONTAINS HUMAN REMAINS, OR THE PLANNING DIRECTOR IF THE DISCOVERY CONTAINS NO HUMAN REMAINS. THE PROCEDURES ESTABLISHED IN SECTIONS 16.40.010 AND 16.42.100, SHALL BE OBSERVED.

THE CONTRACTOR SHALL BE RESPONSIBLE FOR THE VERIFICATION OF CONSTRUCTION QUANTITIES PRIOR TO BIDDING ON ANY ITEM. QUANTITY REFERENCES SHOWN ON THESE PLANS. OR ENGINEER'S ESTIMATES ARE FOR ESTIMATING PURPOSES ONLY AND SHALL NOT BE CONSIDERED AS A BASIS FOR CONTRACTOR PAYMENT. CONSULTANT SHALL NOT BE RESPONSIBLE FOR ANY FLUCTUATIONS IN SUCH QUANTITIES AND ESTIMATES.

18. THE ENGINEER PREPARING THESE PLANS WILL NOT BE RESPONSIBLE FOR, OR LIABLE FOR, UNAUTHORIZED CHANGES TO, OR USES OF, THESE PLANS. ALL CHANGES MUST BE IN WRITING AND MUST BE APPROVED BY THE ENGINEER PRIOR TO CONSTRUCTION.

19. UNDERGROUND UTILITY LOCATIONS SHOWN ARE COMPILED FROM INFORMATION SUPPLIED BY UTILITY AGENCIES, AND ARE APPROXIMATE ONLY. CONTRACTOR SHALL VERIFY LOCATIONS OF AFFECTED UTILITY LINES PRIOR TO ANY TRENCHING OR EXCAVATING AND POTHOLE THOSE AREAS WHERE POTENTIAL CONFLICTS EXIST OR WHERE DATA IS OTHERWISE INCOMPLETE. FOR LOCATION, CALL USA 1-800-624-1444.

20. ANY EXISTING UTILITIES THAT ARE REQUIRED TO BE RELOCATED AS A PART OF THIS CONSTRUCTION SHALL BE RELOCATED AT THE OWNER'S EXPENSE.

EARTHWORK AND GRADING

WORK SHALL CONSIST OF ALL CLEARING, GRUBBING, STRIPPING, PREPARATION OF LAND TO BE FILLED, EXCAVATION, SPREADING, COMPACTION AND CONTROL OF FILL, AND ALL SUBSIDIARY WORK NECESSARY TO COMPLETE THE GRADING TO CONFORM TO THE LINES, GRADES, AND SLOPES, AS SHOWN ON THE APPROVED PLANS.

2. ALL GRADING OPERATIONS SHALL CONFORM TO SECTION 19 OF THE CALTRANS STANDARD SPECIFICATIONS, AND SHALL ALSO BE DONE IN CONFORMANCE WITH THE REQUIREMENTS OF THE COUNTY OF SANTA CRUZ. THE MOST STRINGENT GUIDELINE SHALL

3. THE CONTRACTOR SHALL GRADE TO THE LINE AND ELEVATIONS SHOWN ON THE PLAN AND SHALL SECURE THE SERVICES OF A LICENSED LAND SURVEYOR OR REGISTERED CIVIL ENGINEER TO PROVIDE STAKES FOR LINE AND GRADE.

4. STRIPPED AREAS SHOULD BE SCARIFIED TO A DEPTH OF ABOUT 6", WATER-CONDITIONED TO BRING THE SOILS WATER CONTENT TO ABOUT 2% ABOVE THE OPTIMUM, AND COMPACTED TO A DENSITY EQUIVALENT TO AT LEAST 90% OF THE MAXIMUM DRY DENSITY OF THE SOIL ACCORDING TO ASTM D1557 (LATEST EDITION). SUBGRADES AND AGGREGATE BASE ROCK FOR PAVEMENTS SHOULD BE COMPACTED TO A MINIMUM OF 95%.

5. ENGINEERED FILL SHOULD BE PLACED IN THIN LIFTS NOT EXCEEDING 8" IN LOOSE THICKNESS, MOISTURE CONDITIONED, AND COMPACTED TO AT LEAST 90% RELATIVE


IMPORTED FILL MATERIAL USED AS ENGINEERED FILL FOR THE PROJECT SHALL MEET THE REQUIREMENTS OF THE AFOREMENTIONED GEOTECHNICAL INVESTIGATION.


ALL FILL MATERIAL SHALL BE APPROVED BY THE PROJECT GEOTECHNICAL ENGINEER PRIOR TO JOBSITE DELIVERY AND PLACEMENT. NO EARTHWORK OPERATIONS SHALL BE PERFORMED WITHOUT THE DIRECT OBSERVATION AND APPROVAL OF THE GEOTECHNICAL

BARE GROUND WITHIN 10' OF FOUNDATIONS SHALL BE SLOPED AWAY @ 5% MINIMUM OR 2% MINIMUM FOR PAVED SURFACES.

THRESHOLD DETERMINATION FORM -APPENDIX A

PROJECT DESCRIPTION			
Lot Coverage (measured in square feet)	Actual (sq. ft.)	Adjusted (sq. ft.)*	
A. Total lot size:	15,566		If 814 is > than 1,635,
B. Existing Permitted Impervious Area:	1,635		project shall will be required to mitigate the entire site.**
C. Replaced permitted impervious area:	126		entile site.
D. Replaced permitted semi-impervious area*:	0	0	
D. Proposed new self-treating area:	0		Total replaced impervious & semi-pervious area: 126 sq.fi
E. Proposed new impervious area:	502		
F. Proposed new semi-impervious area*:	371	186	Total proposed impervious & semi-impervious area: 688 sq.ft

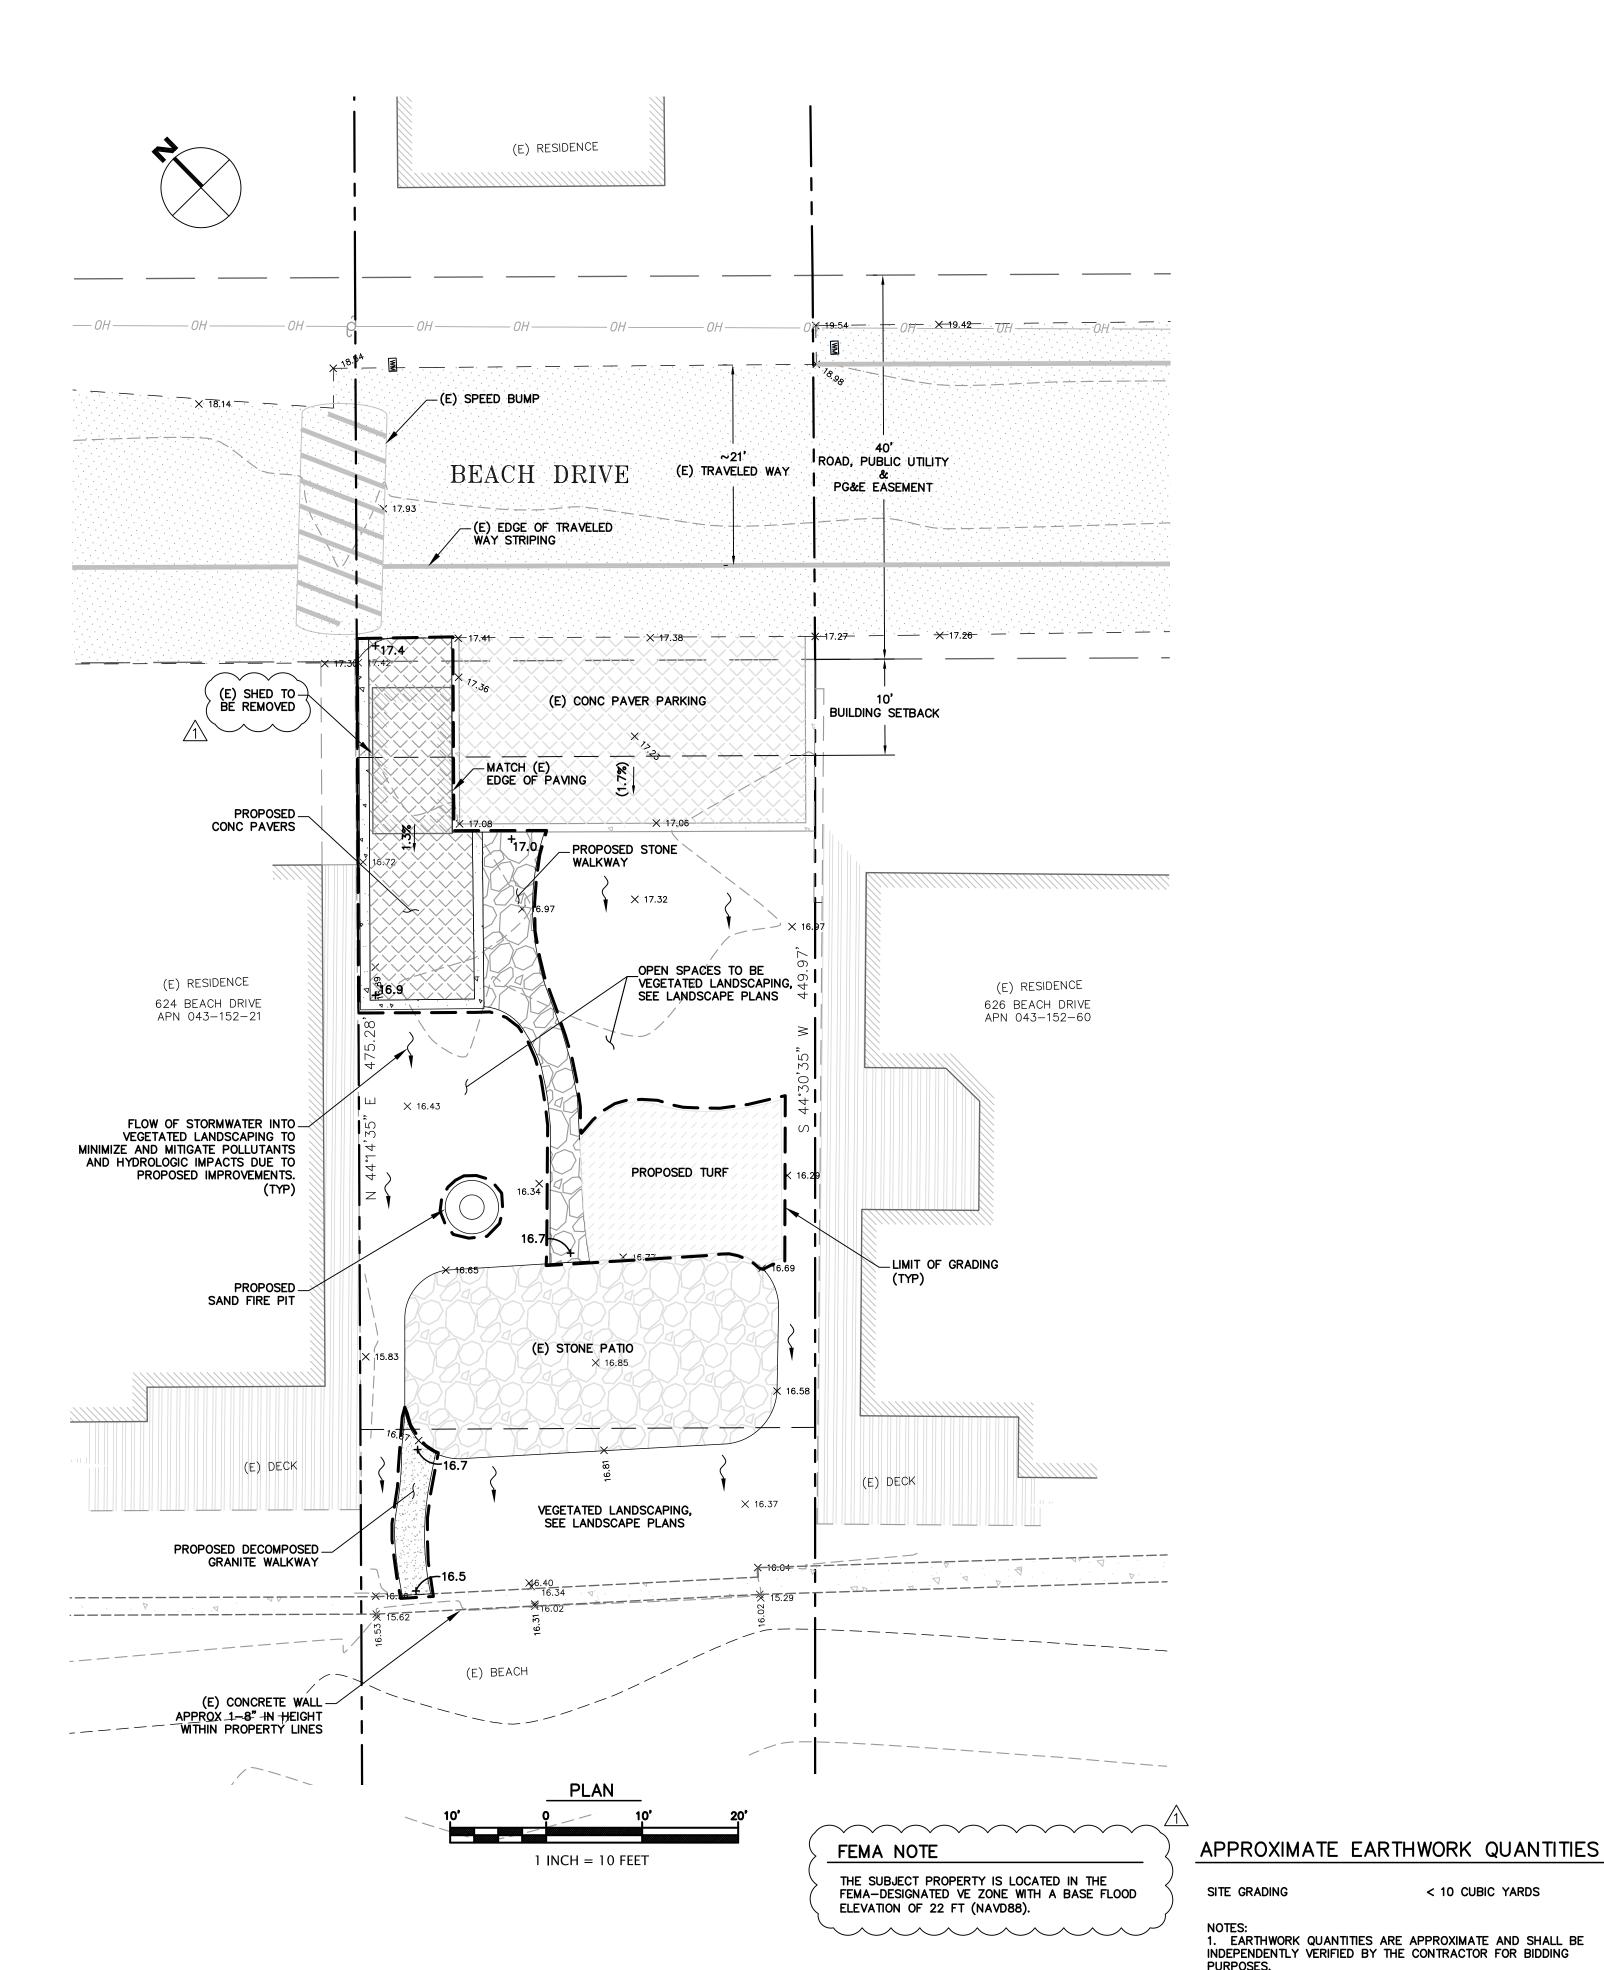

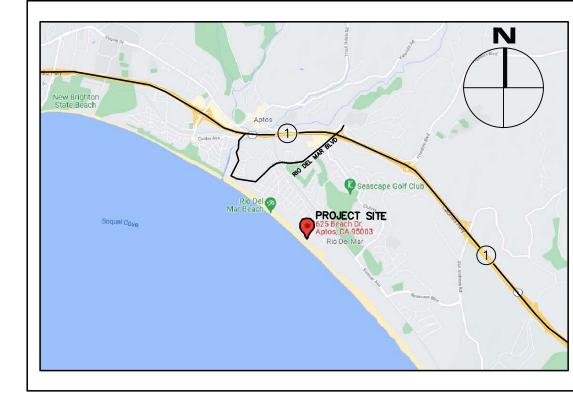

VICINITY MAP

LEGEND	
	(E) AB
	(E) AC
D	(E) CONCRETE
+ + + + + + + + + + + + + + + + + + + +	PROPOSED LANDSCAPING
	PROPOSED CONCRETE PAVERS
	PROPOSED DECOMPOSED GRANITE
	PROPOSED TURF
δ' Δ	PROPOSED CONCRETE
	PROPOSED STONE PAVING
	(E) STRIPING
	PROPERTY LINE
	PROPOSED EASEMENT
	PROPOSED SETBACK
	PROPOSED LIMIT OF GRADING
	TOM OF WALL
CONST CONS	CH BASIN STRUCT IETER
DTL DETA	NSPOUT AIL ÆWAY
(E) EXIS	TING /ATION
FF FINIS	E OF PAVEMENT SH FLOOR SH GRADE
FS FIRE HP HIGH	SERVICE I POINT
LP LOW	AR FEET POINT
N.T.S. NOT	IMUM TO SCALE AINING WALL
RIM RIM S SLOF	ELEVATION PE
SSCO SANI	NTY OF SANTA CRUZ ITARY SEWER CLEANOUT RM DRAIN CLEANOUT
TYP TYPIC TW TOP	
WAIL	

TOPOGRAPHIC SURVEY

THE TOPOGRAPHIC SURVEY AND BOUNDARY INFORMATION PROVIDED HEREON WAS COMPLETED BY HANAGAN LAND SURVEYING. RI ENGINEERING INC. MAKES NO GUARANTEE AS TO THE ACCURACY OF BOTH. THE CONTRACTOR SHALL VERIFY THE BOUNDARY LOCATION AND TOPOGRAPHIC INFORMATION PRIOR TO COMMENCING WORK.

BASIS OF BEARINGS

< 10 CUBIC YARDS

2. EXCESS SOIL SHALL BE HAULED OR PLACED IN A COUNTY

APPROVED LOCATION.


THE BASIS OF BEARING FOR THIS MAP IS BETWEEN FOUND MONUMENTS ON BEACH

BASIS OF ELEVATION


BENCHMARK 479, SANTA CRUZ COUNTY. ELEVATION = 19.08' N.A.V.D. 88THE CONTOUR INTERVAL IS 1 FOOT.

ALL DISTANCES ARE IN FEET AND DECIMALS THEREOF.

DISCRETIONARY PERMIT SUBMITTAL

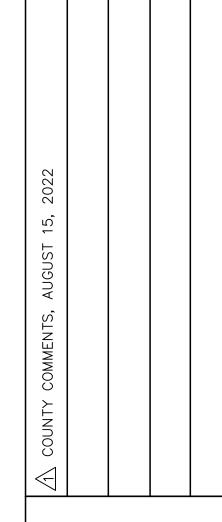



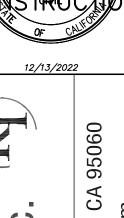


Cri

project no. 21-026-1

DECEMBER 2022

AS SHOWN dwg name

CIVIL2.DWG

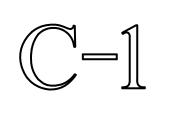

SITE HOUSEKEEPING REQUIREMENTS

CONSTRUCTION MATERIALS 1. ALL LOOSE STOCKPILED CONSTRUCTION MATERIALS THAT ARE NOT ACTIVELY BEING USED (I.E. SOIL, SPOILS, AGGREGATE, FLY-ASH, STUCCO,


- HYDRATED LIME, ETC.) SHALL BE COVERED AND BERMED. 2. ALL CHEMICALS SHALL BE STORED IN WATERTIGHT CONTAINERS (WITH APPROPRIATE SECONDARY CONTAINMENT TO PREVENT ANY SPILLAGE OR
- LEAKAGE) OR IN A STORAGE SHED (COMPLETELY ENCLOSED). 3. EXPOSURE OF CONSTRUCTION MATERIALS TO PRECIPITATION SHALL BE MINIMIZED. THIS DOES NOT INCLUDE MATERIALS AND EQUIPMENT THAT ARE DESIGNED TO BE OUTDOORS AND EXPOSED TO ENVIRONMENTAL CONDITIONS (I.E. POLES, EQUIPMENT PADS, CABINETS, CONDUCTORS,
- INSULATORS, BRICKS, ETC.). BEST MANAGEMENT PRACTICES TO PREVENT THE OFF-SITE TRACKING OF LOOSE CONSTRUCTION AND LANDSCAPE MATERIALS SHALL BE

- LANDSCAPE MATERIALS


 1. CONTAIN STOCKPILED MATERIALS SUCH AS MULCHES AND TOPSOIL WHEN THEY ARE NOT ACTIVELY BEING USED.
- CONTAIN FERTILIZERS AND OTHER LANDSCAPE MATERIALS WHEN THEY ARE NOT ACTIVELY BEING USED.
- DISCONTINUE THE APPLICATION OF ANY ERODABLE LANDSCAPE MATERIAL WITHIN 2 DAYS BEFORE A FORECASTED RAIN EVENT OR DURING PERIOD
- APPLY ERODABLE LANDSCAPE MATERIAL AT QUANTITIES AND APPLICATION RATES ACCORDING TO MANUFACTURE RECOMMENDATIONS OR BASED ON WRITTEN SPECIFICATIONS BY KNOWLEDGEABLE AND EXPERIENCED FIELD
- 5. STACK ERODABLE LANDSCAPE MATERIAL ON PALLETS AND COVERING OR STORING SUCH MATERIALS WHEN NOT BEING USED OR APPLIED.


VEHICLE STORAGE AND MAINTENANCE 1. MEASURES SHALL BE TAKEN TO PREVENT OIL, GREASE, OR FUEL TO LEAK IN TO THE GROUND, STORM DRAINS OR SURFACES WATERS.

- ALL EQUIPMENT OR VEHICLES, WHICH ARE THE BE FUELED, MAINTAINED AND STORED ONSITE SHALL BE IN A DESIGNATED AREA FITTED WITH
- 3. LEAKS SHALL BE IMMEDIATELY CLEANED AND LEAKED MATERIALS SHALL
- BE DISPOSED OF PROPERLY. WASTE MANAGEMENT DISPOSAL OF ANY RINSE OR WASH WATERS OR MATERIALS ON
- IMPERVIOUS OR PERVIOUS SITE SURFACES OR INTO THE STORM DRAIN SYSTEM SHALL BE PREVENTED. 2. SANITATION FACILITIES SHALL BE CONTAINED (E.G., PORTABLE TOILETS) TO PREVENT DISCHARGES OF POLLUTANTS TO THE STORM WATER
- DRAINAGE SYSTEM OR RECEIVING WATER, AND SHALL BE LOCATED A MINIMUM OF 20 FEET AWAY FROM AN INLET, STREET OR DRIVEWAY, STREAM, RIPARIAN AREA OR OTHER DRAINAGE FACILITY.
- SANITATION FACILITIES SHALL BE INSPECTED REGULARLY FOR LEAKS AND SPILLS AND CLEANED OR REPLACED AS NECESSARY.
- COVER WASTE DISPOSAL CONTAINERS AT THE END OF EVERY BUSINESS DAY AND DURING A RAIN EVENT.
 DISCHARGES FROM WASTE DISPOSAL CONTAINERS TO THE STORM WATER
- DRAINAGE SYSTEM OR RECEIVING WATER SHALL BE PREVENTED.
- STOCKPILED WASTE MATERIAL SHALL BE CONTAINED AND SECURELY PROTECTED FROM WIND AND RAIN AT ALL TIMES UNLESS ACTIVELY BEING
- PROCEDURES THAT EFFECTIVELY ADDRESS HAZARDOUS AND NON-HAZARDOUS SPILLS SHALL BE IMPLEMENTED.
- 8. EQUIPMENT AND MATERIALS FOR CLEANUP OF SPILLS SHALL BE AVAILABLE ON SITE AND THAT SPILLS AND LEAKS SHALL BE CLEANED
- UP IMMEDIATELY AND DISPOSED OR PROPERLY; AND CONCRETE WASHOUT AREAS AND OTHER WASHOUT AREAS THAT MAY
- CONTAIN ADDITIONAL POLLUTANTS SHALL BE CONTAINED SO THERE IS NO DISCHARGE INTO THE UNDERLYING SOIL AND ONTO THE SURROUNDING

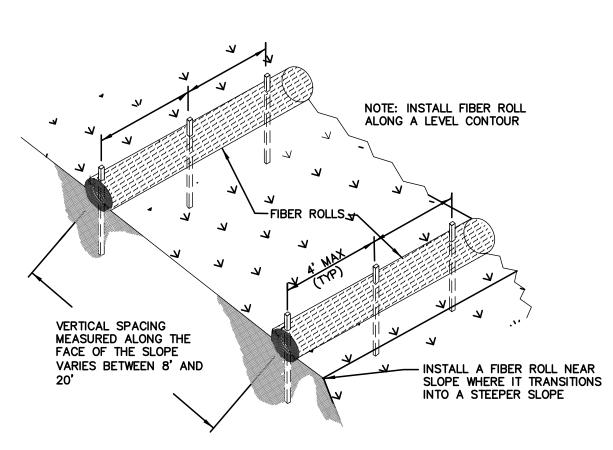

TYPICAL FIBER ROLL INSTALLATION

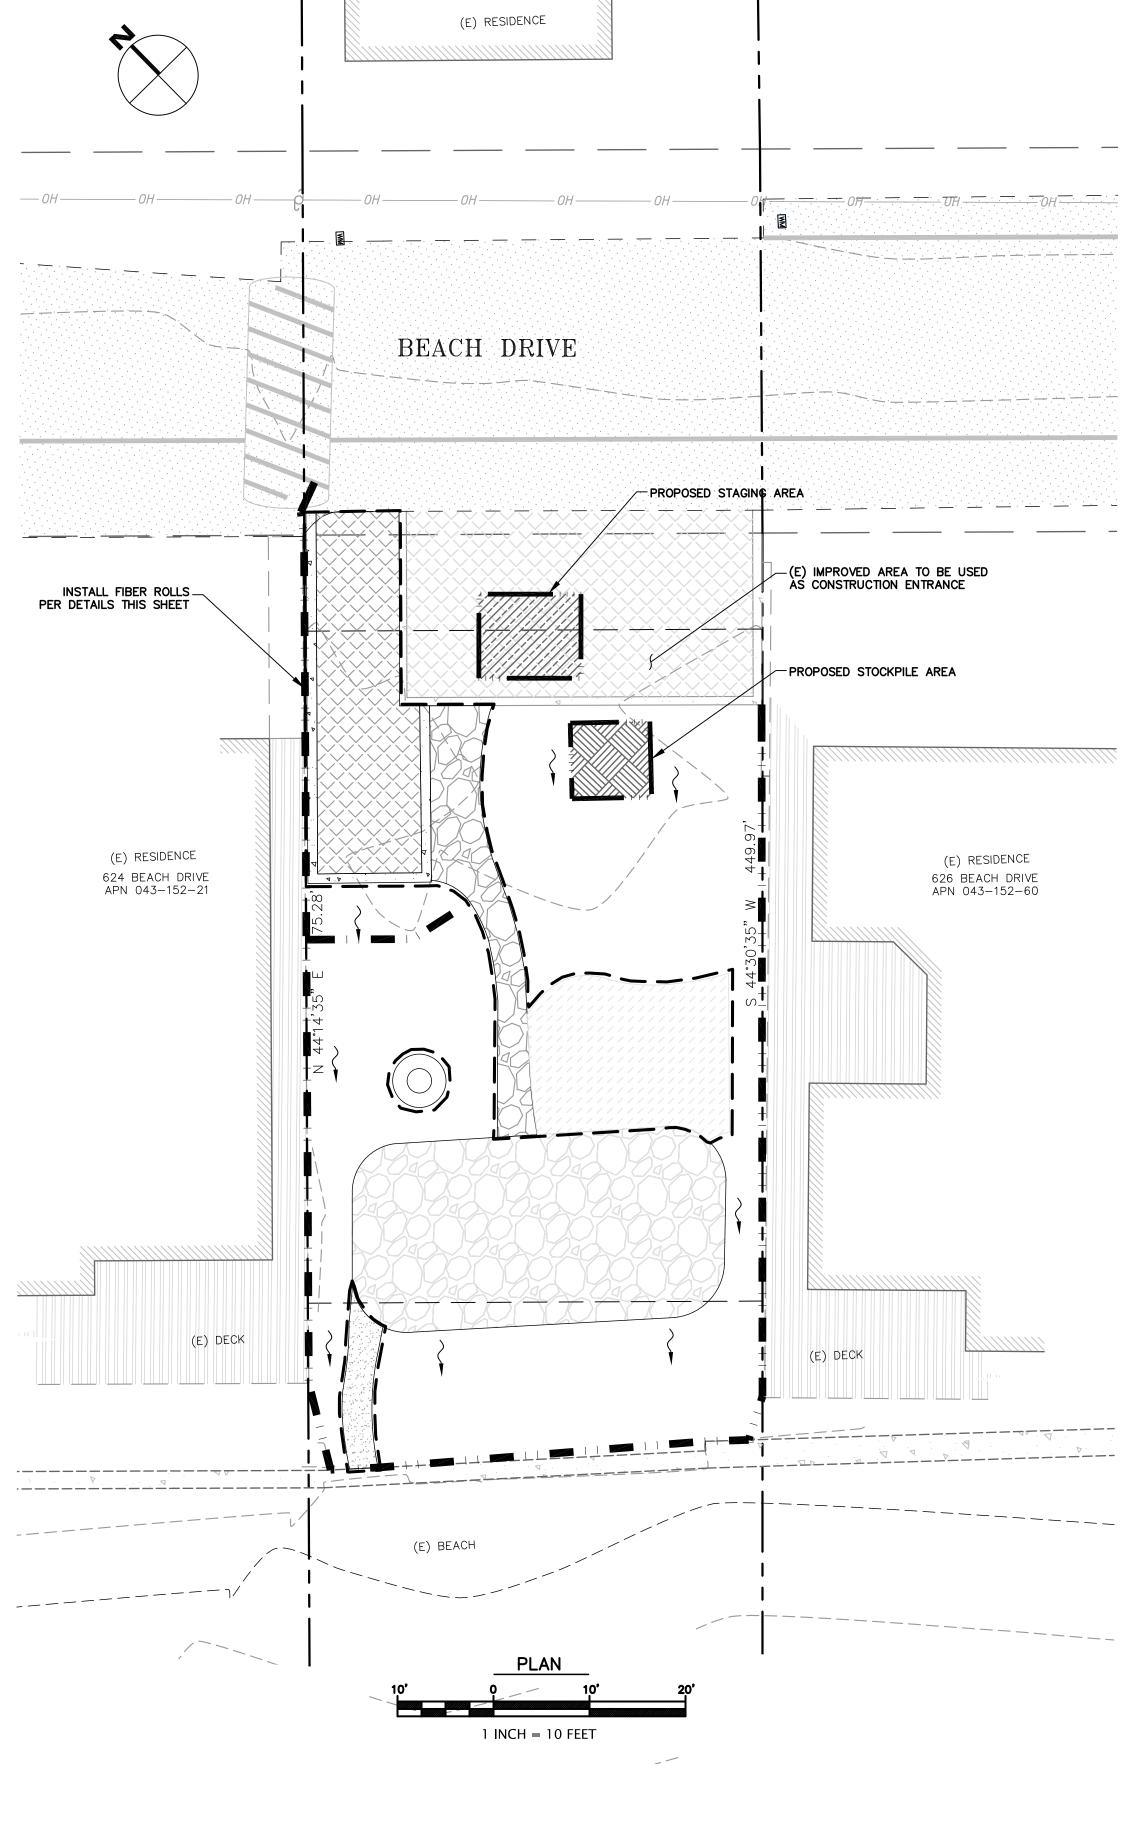

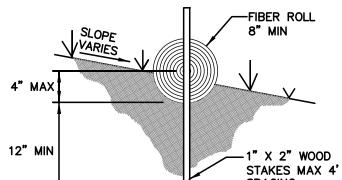

FIBER ROLL DETAIL IN SLOPE AREA

EROSION CONTROL MEASURES

- EROSION IS TO BE CONTROLLED AT ALL TIMES ALTHOUGH SPECIFIC MEASURES SHOWN ARE TO BE IMPLEMENTED AT A MINIMUM BY OCTOBER 15.
- 2. UNLESS SPECIFIC MEASURES ARE SHOWN OR NOTED ON THIS PLAN, ALL COLLECTED RUNOFF SHALL BE CARRIED TO DRAINAGE COURSES IN LINED CONDUITS. DISCHARGE SHALL BE IN THE LOCATIONS SHOWN ON THE PLANS.
- 3. THE DESIRED END RESULT OF THESE MEASURES IS TO CONTROL SITE EROSION AND PREVENT SEDIMENT TRANSPORT OFF THE SITE. IT SHALL BE THE DEVELOPER'S RESPONSIBILITY TO SEE THAT ANY ADDITIONAL MEASURES NECESSARY TO MEET THIS GOAL ARE IMPLEMENTED. IF FAILED INSPECTIONS BY COUNTY STAFF SHOW THIS GOAL IS NOT BEING MET, ADDITIONAL MEASURES MAY BE REQUIRED.
- 4. ALL DISTURBED AREAS NOT CURRENTLY BEING USED FOR CONSTRUCTION SHALL BE SEEDED WITH THE FOLLOWING SEED MIXTURE:

WINTER BARLEY 25#/ACRE

- 5. AFTER SEEDING, STRAW MULCH WILL BE APPLIED IN 4" (AVG.) LAYERS.
- AMMONIUM PHOSPHATE FERTILIZER, 6-3-3, SHALL BE APPLIED AT A RATE OF 30 LBS. PER ACRE. ON SLOPES GREATER THAN 20% EROSION CONTROL BLANKET (NORTH AMERICAN GREEN) SHALL BE APPLIED.
- 7. SILT BARRIERS SHALL BE PLACED END TO END AND STAKED DOWN ALONG THE BOTTOM OF ALL GRADED

ALL EROSION CONTROL MEASURES INCLUDING BUT NOT LIMITED TO SILT FENCES, FIBER ROLLS AND SLOPE PROTECTION SHALL BE IN PLACE BY OCTOBER 15TH. THE ENGINEER OF RECORD SHALL INSPECT ONCE EROSION CONTROL MEASURES HAVE BEEN INSTALLED.

EROSION CONTROL LEGEND



INSTALL FIBER ROLL PER DETAILS



PROPOSED STOCKPILE AREA



PROPOSED STAGING AREA



Cruz, \Box

project no.

21-026-1 DECEMBER 2022

AS SHOWN

CIVIL2.DWG

